


| ITEM # | QTY | PART # | TITLE | PG |
|--------|-----|---------------------------------------|--|----|
| -1 | 3 | RBEM623U1002102-1 | LIFTING CLEVIS | 2 |
| -23 | 3 | RBEM623U1002102-23 | STRAP ASSY | 3 |
| 27 | 1 | RB41011 | DART PLACARD | - |
| 5 | 1 | McMaster#7163T12 | OBLONG LINK W/COUPLINGS LINKS 7/8" GRADE 100 | - |
| 7 | 3 | PEWAG#CARW 10 OR CROSBY S-237#1020695 | SLING CONNECTOR | - |
| 9 | 3 | McMaster#90985A335 | QUICK RELEASE PIN 7/16" x 2-1/2" USABLE | - |
| 11 | 3 | SPENCER AIRCRAFT# AN5-27 | HEX HEAD CAP SCREW | - |
| 13 | 6 | SPENCER AIRCRAFT# AN960-516 | FLAT WASHER | - |
| 15 | 3 | SPENCER AIRCRAFT# AN310-5 | CASTLE NUT | - |
| 17 | 3 | McMaster#98338A175 | COTTER PIN 1/8" x 3/4" | - |
| 19 | A/R | CARR LANE#CL-2-C | NYLON COATED WIRE 1/16" | - |
| 21 | 8 | McMaster#3896T31 | FERRULE 1/16" DIA. x 3/8" | - |


| REV. | DESCRIPTION | ECN # | DATE | BY | APPROVED |
|------|--|--------|----------|-----|----------|
| 1 | RELEASE FOR PRODUCTION | - | 1/7/2016 | RJC | JAG |
| B | ITEM# -23 ASSY ADDED, MATERIAL SPECIFICATION ADDED TO ITEM# -3, TEMPLATE UPDATED, ITEM# -25 ADDED, WEIGHT TEST DRAWING ADDED ON SHEET 7, PLACARD DRAWING ADDED ON SHEET 6, NOTE 3 ON SHEET 1 BECOME NOTE 7 AND TYPO CORRECTED | 17-702 | 17.10.06 | VM | WM |
| C | TULMAR DRAWING'S MARKUPS ADDED; TULMAR P/N ADDED & QTY OF -25 CHANGED TO 4 & NOTE 10 CHANGED & NOTE 11 ADDED & SECTION A-A ADDED & DETAIL VIEW B-B ADDED & LENGTH OF -25 INCREASE TO 4.1" ON -23 DRAWING, DIMENSION OF 44.9 DECREASE TO 42 & DIMENSION OF .06 CHANGED TO .05 & NOTE 1 CHANGED ON -3 DRAWING, DIMENSION OF 12.5 CHANGED TO 8.75 & DIMENSION OF .2 CHANGED TO .05 & NOTE 1 CHANGED ON -25 DRAWING, TULMAR TOLERANCE ADDED, -26 DRAWING ADDED | 17-756 | 17.11.22 | VM | WM |

RBEM623U1002102 SWASHPLATE SLING

- NOTES:
- 1) MATERIAL: N/A
 - 2) HEAT TREAT: N/A
 - 3) FINISH: N/A
 - 4) SPEC: N/A
 - 5) BREAK ALL SHARP EDGES: N/A
 - 6) IDENTIFICATION: ENGRAVE "SWL 75 LBS, LOAD TESTED 90 LBS" & P/N & S/N WHERE INDICATED
 - 7) REF. AIRBUS T/N M632U1002102
 - 8) ATTACH ITEM# 19 LANYARD TO ITEM# 5 AND ITEM #27 DART PLACARD
 - 9) ATTACH ITEM# 19 LANYARD TO -17 COTTER PIN AND -9 QUICK RELEASE PIN

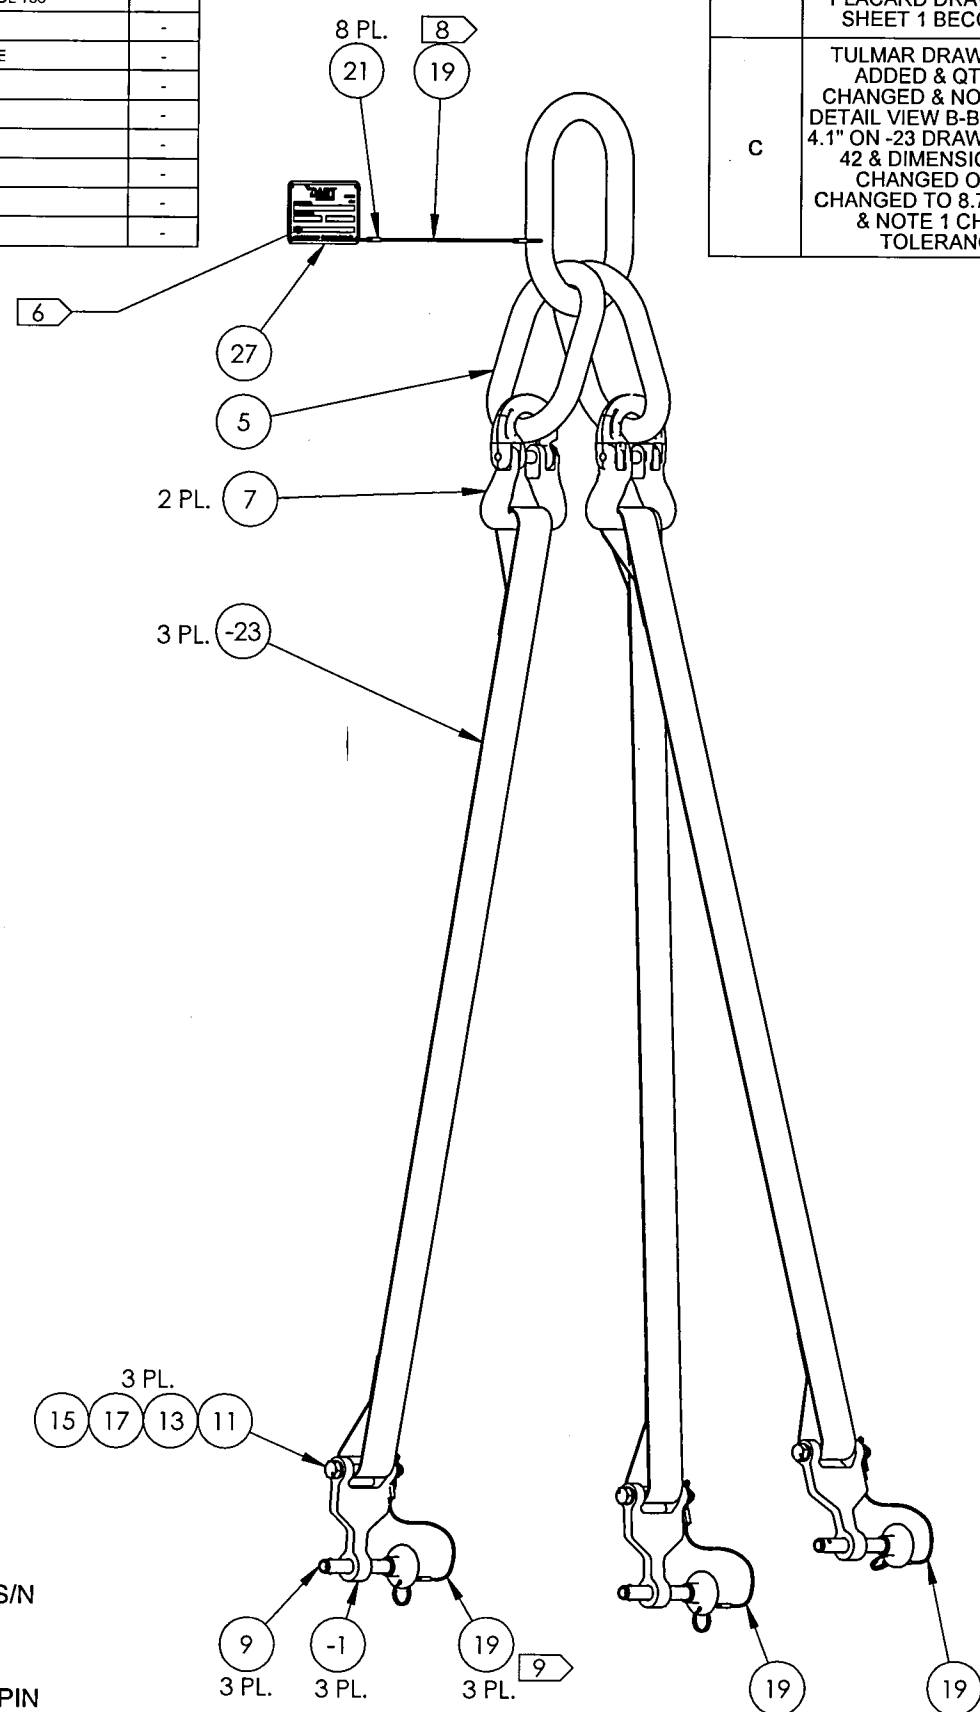

SEE ATTACHED DEVIATION



DART
AEROSPACE

Hawkesbury, Ontario, Canada

TITLE

SWASHPLATE SLING

DWG NO.

RBEM623U1002102

REV

C

DESIGN BY:

VM 10/6/2017

DRAWN BY:

VM 11/28/2017

CHECKED:

WM 11/28/2017

MFG. APPR:

DP 11/29/2017

APPROVED:

WM 11/29/2017

DATE:

11/28/2017

SCALE:

NTS

WEIGHT:

N/A

SHEET 1 OF 7

1. DIMENSIONS ARE IN INCHES UNLESS OTHERWISE SPECIFIED

2. INTERPRET DIM AND TOL PER ASME Y14.5M-2009

3. DIMENSIONAL LIMITS APPLY AFTER PLATING

COPYRIGHT © 2017 BY DART AEROSPACE LTD

THIS DOCUMENT IS PRIVATE AND CONFIDENTIAL AND IS SUPPLIED ON THE EXPRESS CONDITION THAT IT IS NOT TO BE USED FOR ANY PURPOSE OR COPIED OR COMMUNICATED TO ANY OTHER PERSON WITHOUT WRITTEN PERMISSION FROM DART AEROSPACE LTD.




8 7 6 5 4 3 2 1

D

C

B

A

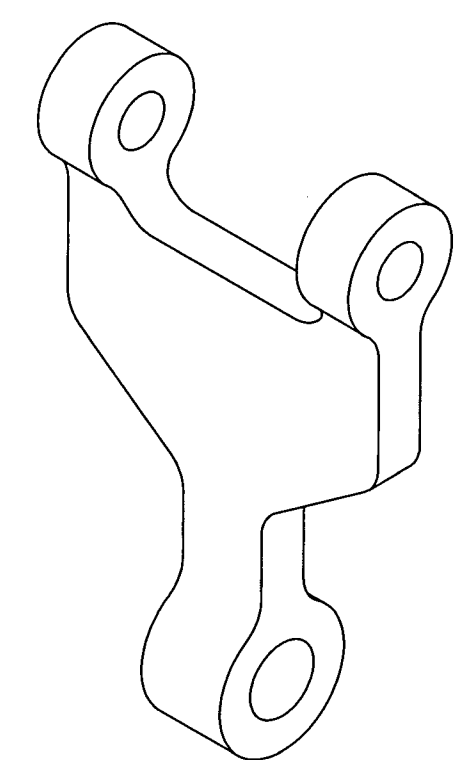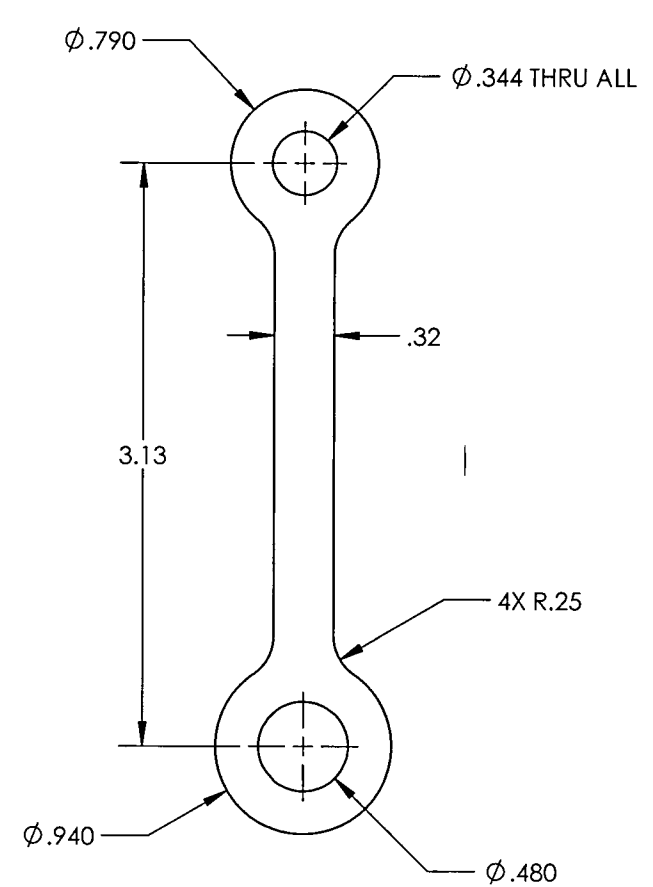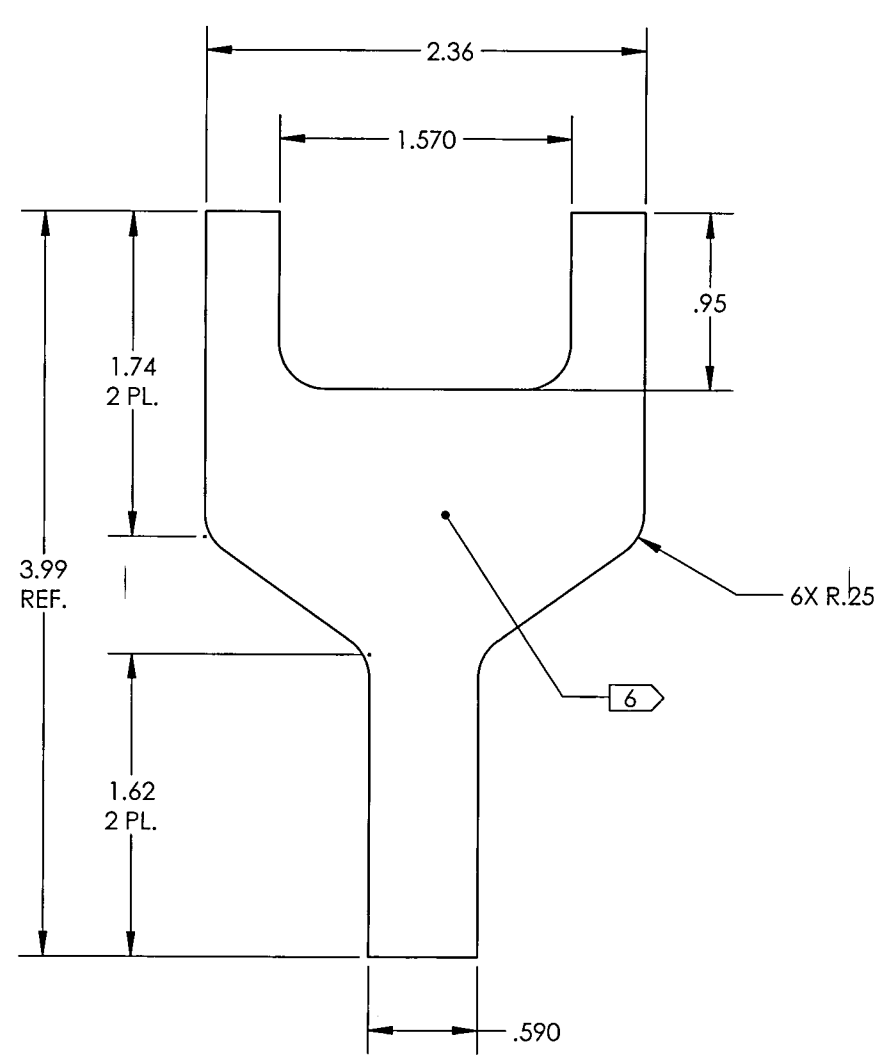

D

C


B

A

RBEM623U1002102-1 LIFTING CLEVIS




- NOTES:
- 1) MATERIAL: AISI 1018/1020 CR
 - 2) HEAT TREAT: N/A
 - 3) FINISH: POWDER COAT YELLOW PROTECH# HS112Y12
 - 4) SPEC: N/A
 - 5) BREAK ALL SHARP EDGES .015 x 45° OR .015R
 - 6) IDENTIFICATION: INK STAMP P/N

SEE ATTACHED DEVIATION

| | | | |
|--|---------------|--|-----------|
|  Hawkesbury, Ontario, Canada | | | |
| TITLE LIFTING CLEVIS | | | |
| DWG NO. RBEM623U1002102-1 | | | REV C |
| DESIGN BY: | VM 10/6/2017 | .XXX ± .005 FRACTIONS ± 1/8 | |
| DRAWN BY: | VM 11/28/2017 | XX ± .01 ANGLES ± 5° | |
| CHECKED: | WM 11/28/2017 | X ± .1 SURFACES = 125 | |
| MFG. APPR: | DP 11/29/2017 | 1. DIMENSIONS ARE IN INCHES UNLESS OTHERWISE SPECIFIED | |
| APPROVED: | WM 11/29/2017 | 2. INTERPRET DIM AND TOL PER ASME Y14.5M-2009 | |
| DATE: | 11/28/2017 | 3. DIMENSIONAL LIMITS APPLY AFTER PLATING | |
| SCALE: | NTS | WEIGHT: | 0.485 LBS |
| | | SHEET 2 OF 7 | |
| COPYRIGHT © 2017 BY DART AEROSPACE LTD | | | |
| THIS DOCUMENT IS PRIVATE AND CONFIDENTIAL AND IS SUPPLIED ON THE EXPRESS CONDITION THAT IT IS NOT TO BE USED FOR ANY PURPOSE OR COPIED OR COMMUNICATED TO ANY OTHER PERSON WITHOUT WRITTEN PERMISSION FROM DART AEROSPACE LTD. | | | |

8 7 6 5 4 3 2 1

| ITEM # | QTY | PART # | TITLE | PG |
|--------|-----|--------------------|----------------------------|----|
| -3 | 1 | RBEM623U1002102-3 | STRAP | 4 |
| -25 | 2 | RBEM623U1002102-25 | WEB SLING PROTECTORS INNER | 5 |
| -26 | 2 | RBEM623U1002102-26 | WEB SLING PROTECTORS OUTER | 6 |

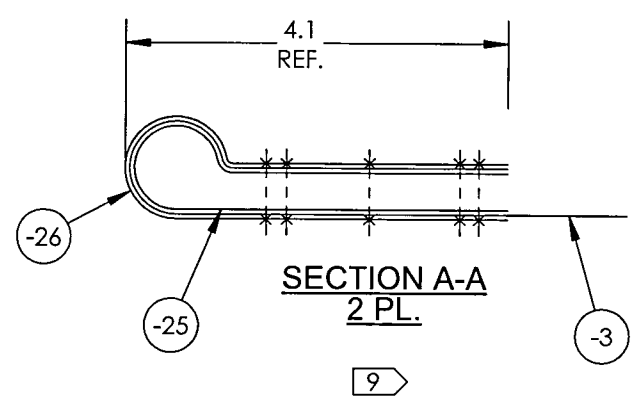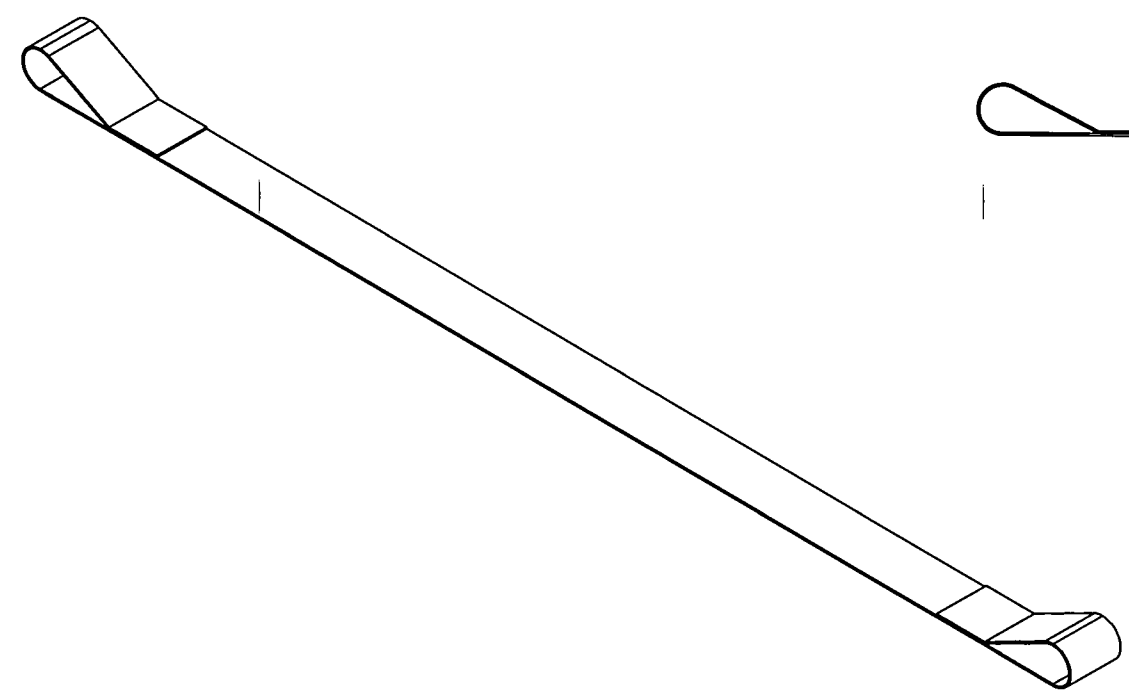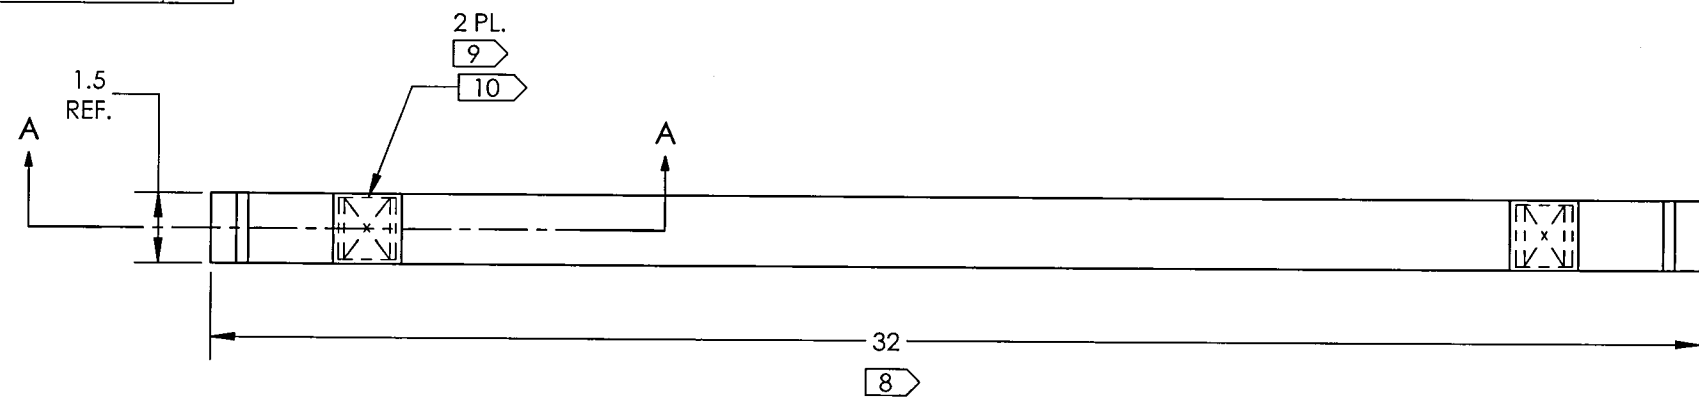


| TOLERANCES |
|-----------------------|
| +/- .125" < 2" |
| +/- .250" 2 TO < 10" |
| +/- .500" 10 TO < 20" |
| +/- .625" 20 TO < 40" |
| +/- 1.5% = OR > 40" |
| +/- 5° ON ALL ANGLES |


SEE ATTACHED DEVIATION


- NOTES:
- 1) MATERIAL: RBEM623U1002102-23 STRAP ASSY SUPPLIED BY TULMAR 87345-001
 - 2) HEAT TREAT: N/A
 - 3) FINISH: N/A
 - 4) SPEC: N/A
 - 5) BREAK ALL SHARP EDGES: N/A
 - 6) IDENTIFICATION: N/A
 - 7) SAFETY CERTIFICATE REQUIRED FOR SWL OF 75 LBS
 - 8) FINAL LENGTH OF SEWN STRAP
 - 9) USE TULMAR 2544, THREAD, NYLON, RED, A-A-59826, TY2, CLA, SIZE F, FOR ALL SEWING
 - 10) 1-1/4 x 1-1/4 FLAG
 - 11) USE THIS TOLERANCE INSTEAD OF THE STANDARDS TOLERANCES IN THE TITLE BLOCK UNLESS OTHERWISE SPECIFIED


RBEM623U1002102-23 STRAP ASSY

| | |
|--|--|
| DART AEROSPACE Hawkesbury, Ontario, Canada | |
| TITLE STRAP ASSY | |
| DWG NO. RBEM623U1002102-23 | REV C |
| DESIGN BY: VM 10/6/2017 | XXX ± .005 FRACTIONS ± 1/8 |
| DRAWN BY: VM 11/28/2017 | XX ± .01 ANGLES ± 5° |
| CHECKED: WM 11/28/2017 | X ± .1 SURFACES = 125 |
| MFG. APPR: DP 11/29/2017 | 1. DIMENSIONS ARE IN INCHES UNLESS OTHERWISE SPECIFIED |
| APPROVED: WM 11/29/2017 | 2. INTERPRET DIM AND TOL PER ASME Y14.5M-2009 |
| DATE: 11/28/2017 | 3. DIMENSIONAL LIMITS APPLY AFTER PLATING |
| SCALE: NTS | WEIGHT: N/A |
| SHEET 3 OF 7 | |
| COPYRIGHT © 2017 BY DART AEROSPACE LTD THIS DOCUMENT IS PRIVATE AND CONFIDENTIAL AND IS SUPPLIED ON THE EXPRESS CONDITION THAT IT IS NOT TO BE USED FOR ANY PURPOSE OR COPIED OR COMMUNICATED TO ANY OTHER PERSON WITHOUT WRITTEN PERMISSION FROM DART AEROSPACE LTD. | |

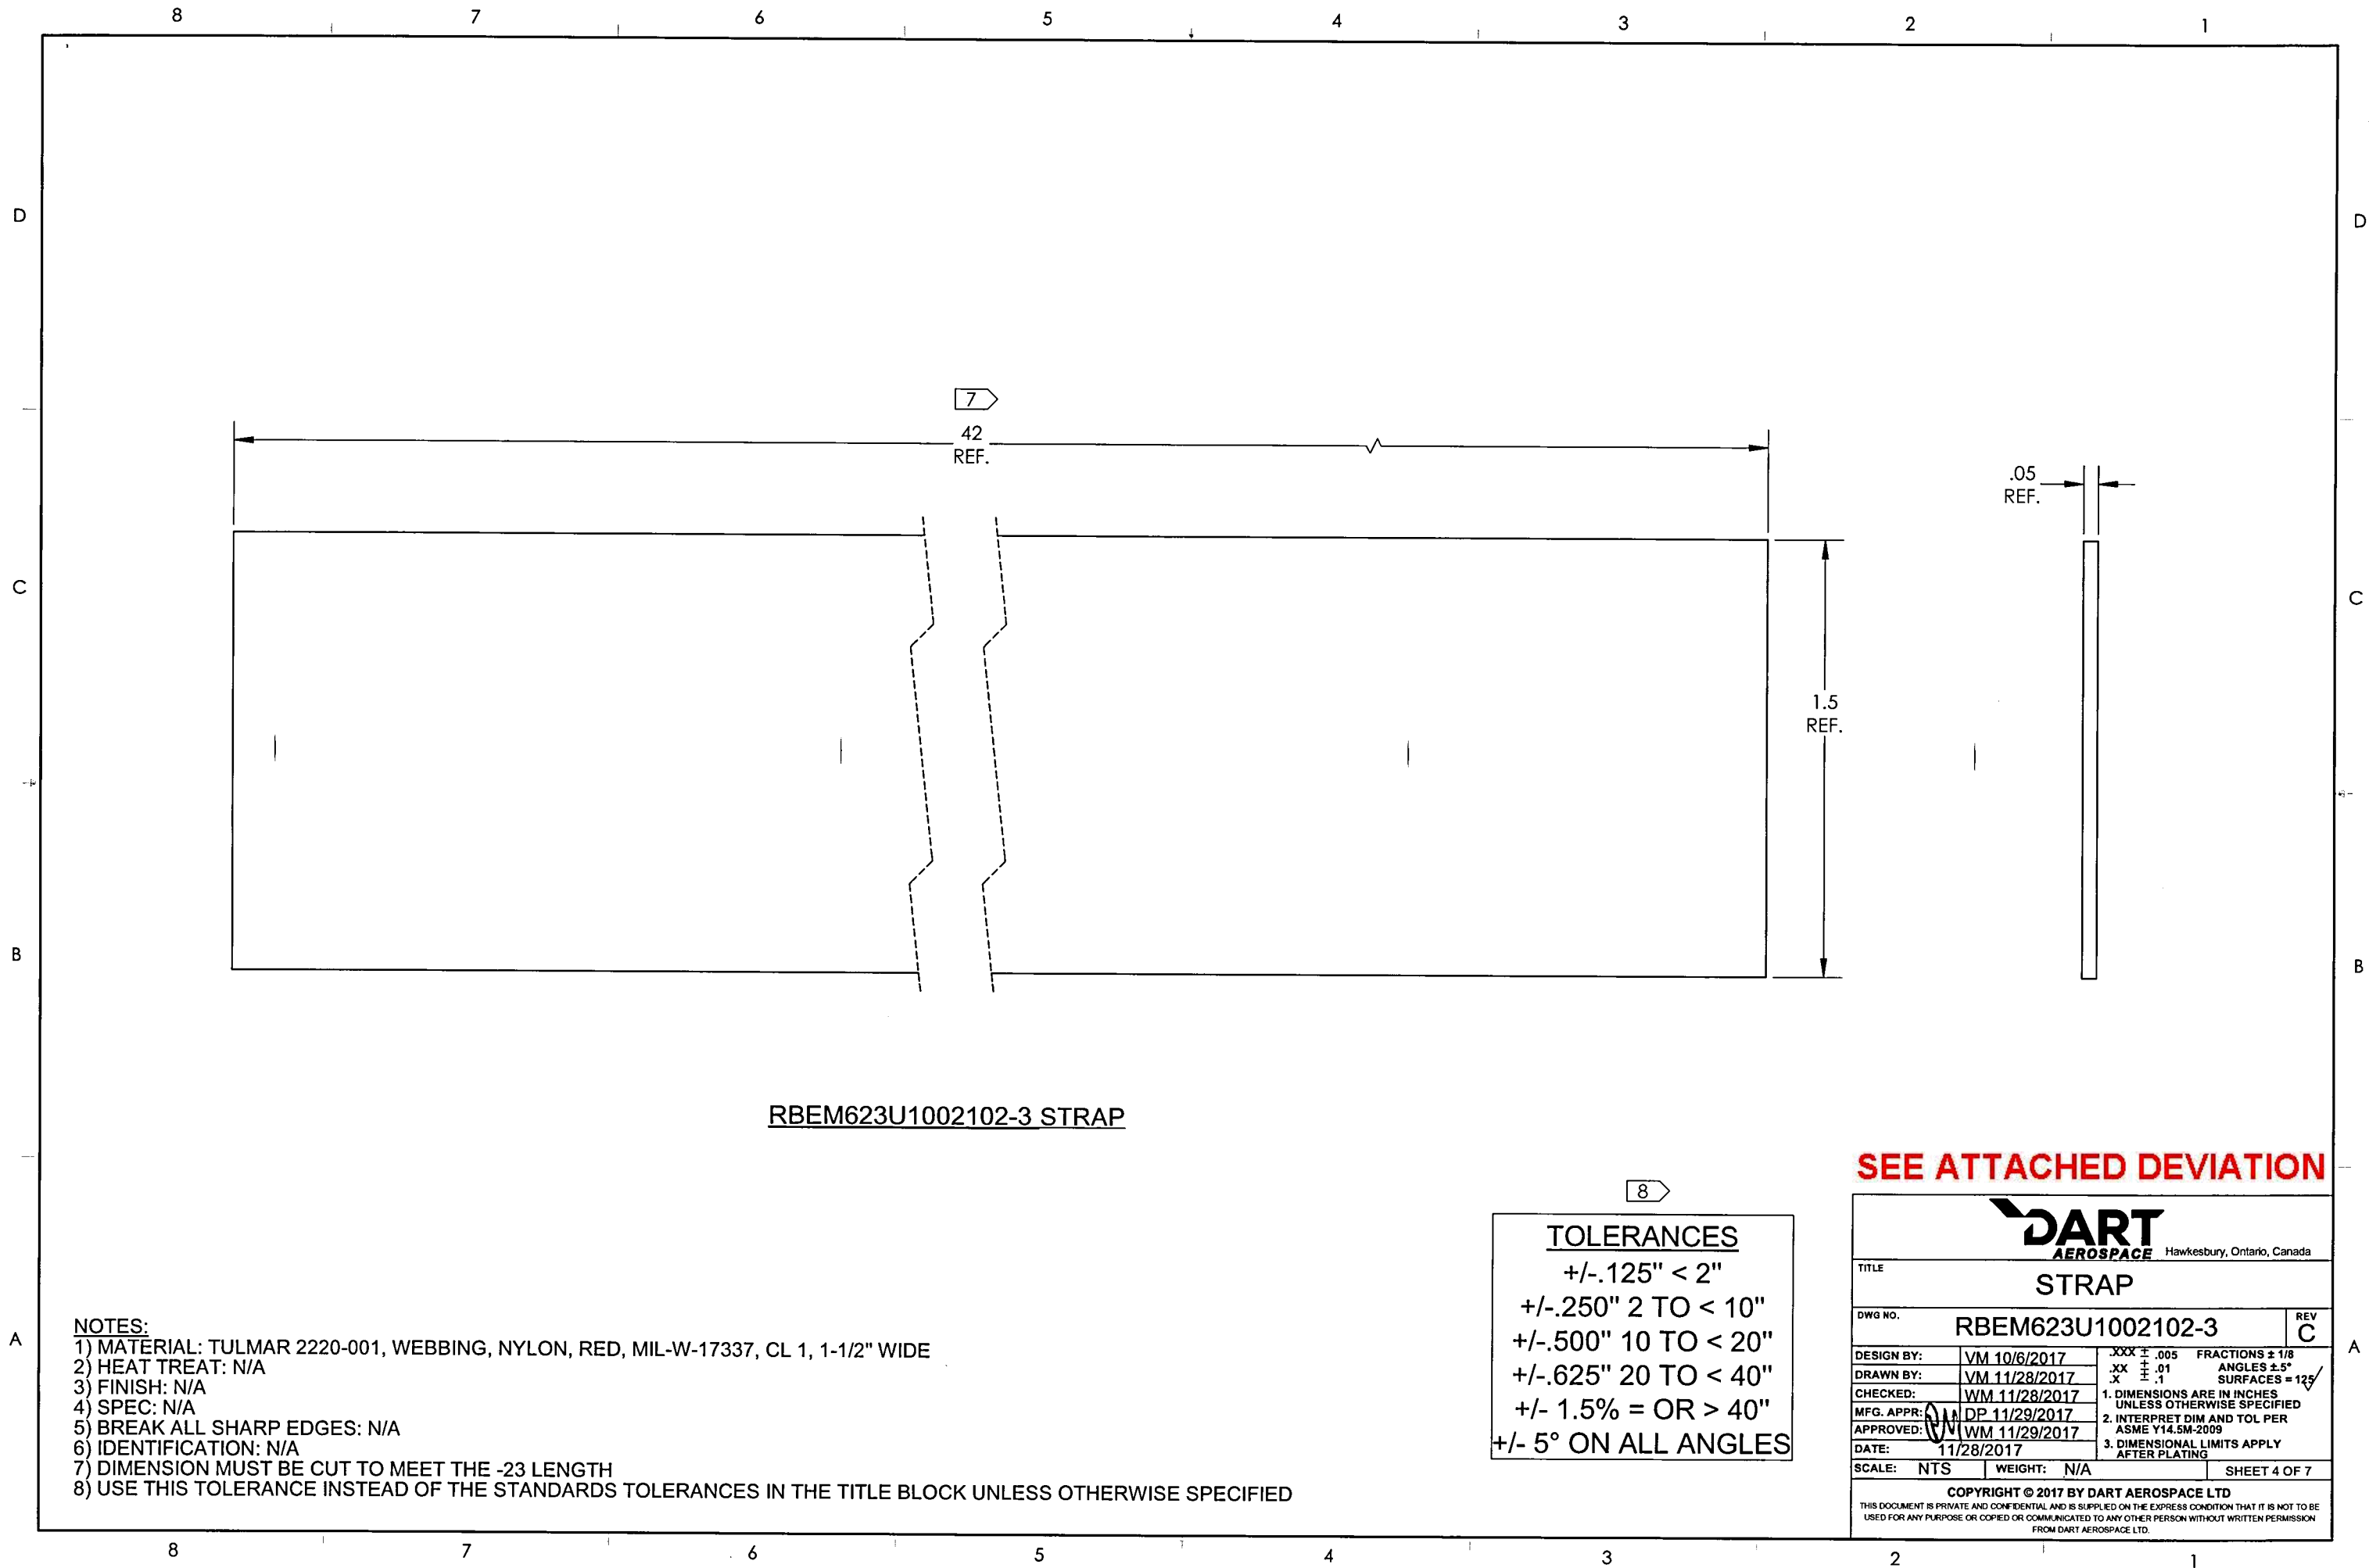

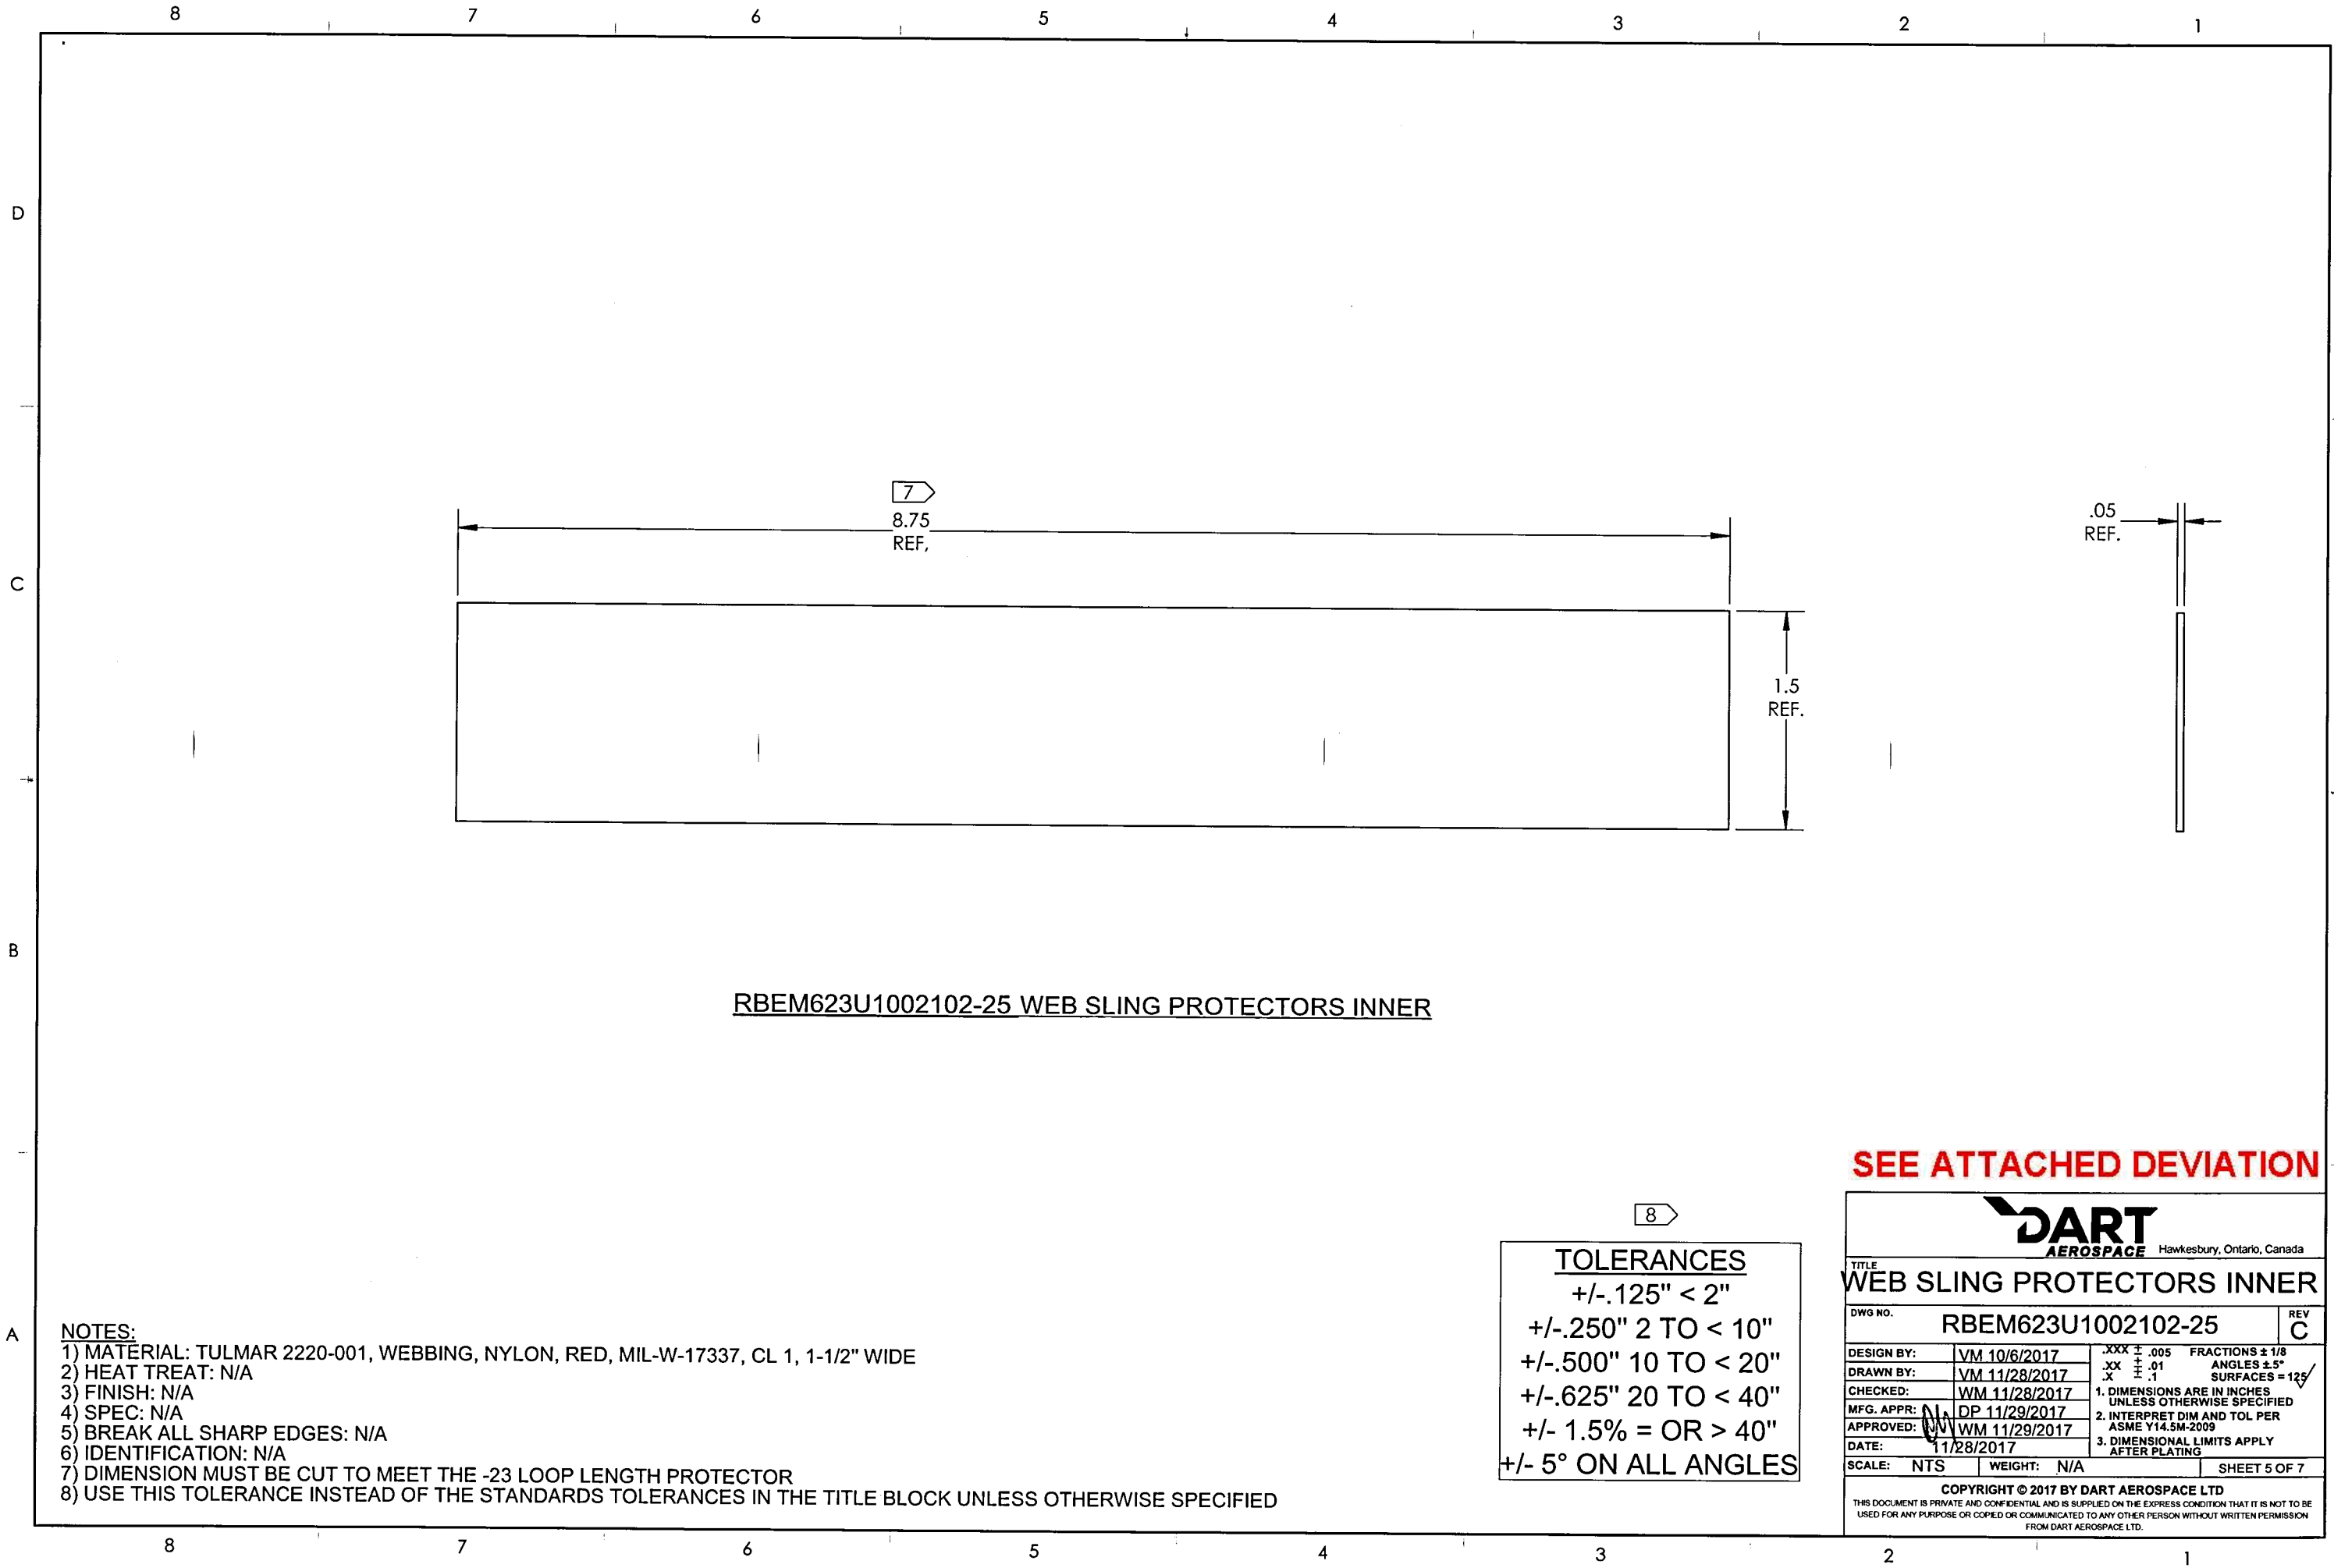

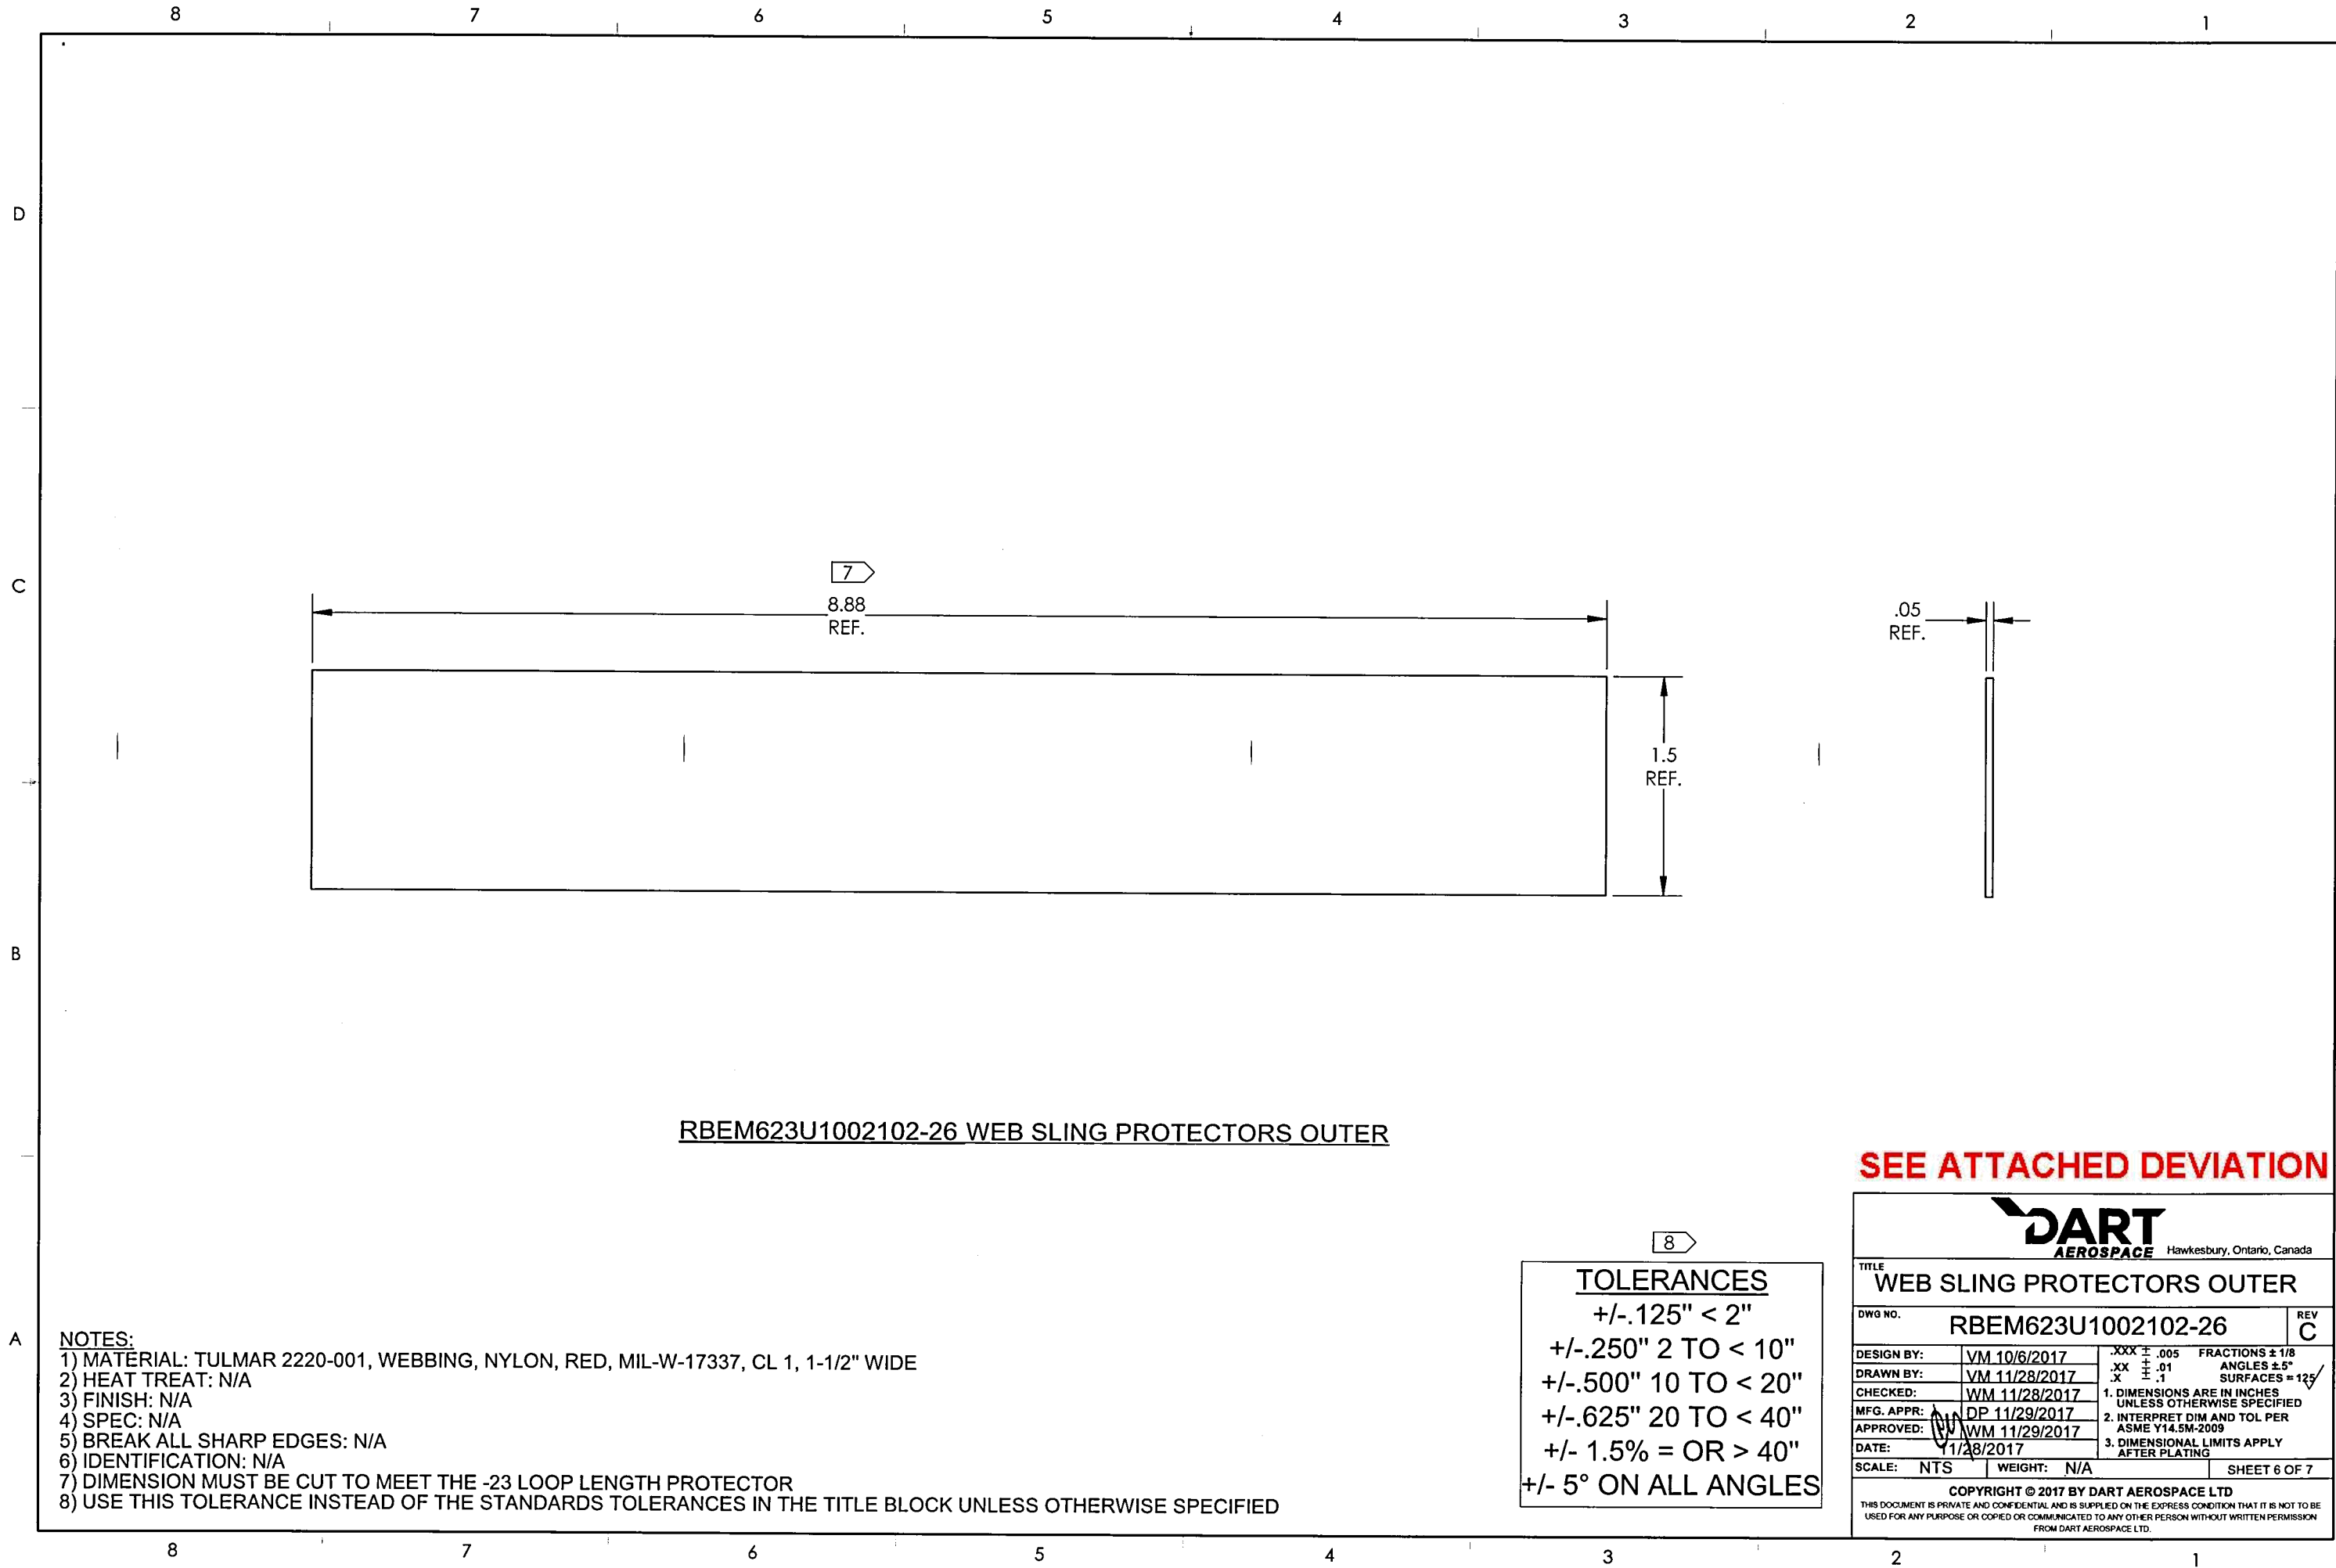

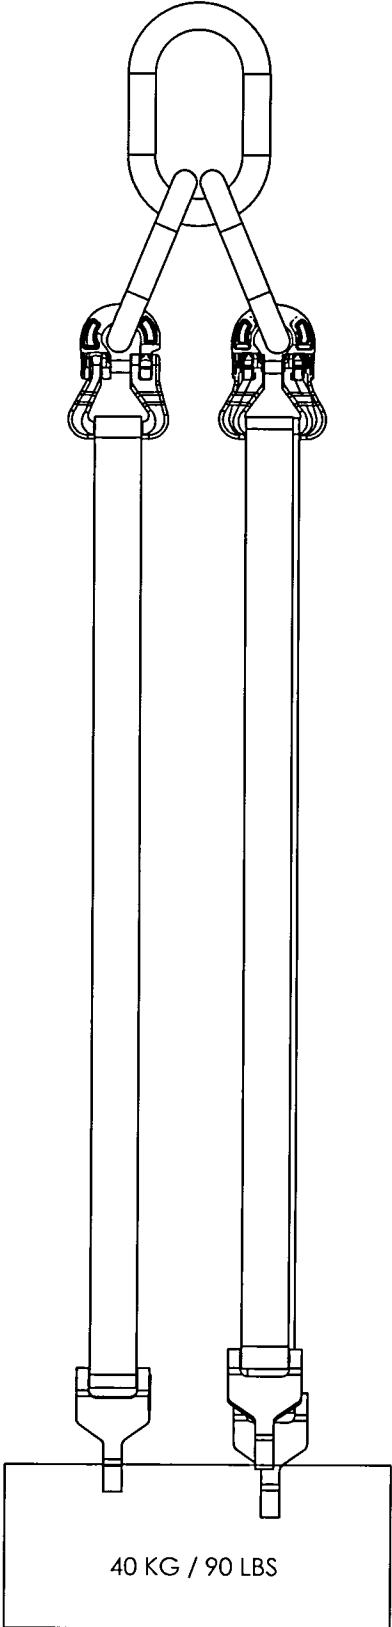


INSPECTION & TESTING PROCEDURES FOR THE RBEM623U1002102, UPPER STOPS AND FAIRING SLING. THIS SLING IS DESIGNED FOR HOISTING AND INSTALLING/REMOVING THE H175 COWLING. THIS SLING ASSEMBLY SHOULD BE INSPECTED BEFORE EACH USE. REPLACE ANY ITEMS THAT ARE DAMAGED OR SUSPECTED OF DAMAGE BEFORE USING!

- FIRST ARTICLE WEIGHT TEST
- 1. AFTER INSPECTION, PLACE SLING ASSEMBLY ON AN OVERHEAD LIFTING DEVICE. ATTACH SLING TO AN APPROPRIATE TEST WEIGHT TEST WEIGHT OF 40Kg / 90 LBS.
 - 2. LIFT WEIGHT FOR AT LEAST 5 MINUTES, CONTINUALLY CHECKING FOR CRACKS, DEFLECTION, DISTORTION OR DAMAGED/FRAYED STRAPS.
 - 3. REMOVE WEIGHT AND RE-INSPECT SLING, CHECKING FOR STRESS CRACKS, BENDING, DISTORTIONS OR DAMAGED/FRAYED STRAPS.

INSPECTOR: _____
TESTER: _____
S.N.: _____
DATE: _____

SEE ATTACHED DEVIATION

| | | | |
|---|---------------|--|-----------------|
|  Hawkesbury, Ontario, Canada | | | |
| TITLE SWASHPLATE SLING | | | |
| DWG NO. RBEM623U1002102 | | | REV C |
| DESIGN BY: | VM 10/6/2017 | .XXX ± .005 | FRACTIONS ± 1/8 |
| DRAWN BY: | VM 11/28/2017 | .XX ± .01 | ANGLES ± 5° |
| CHECKED: | WM 11/28/2017 | X ± .1 | SURFACES = 125 |
| MFG. APPR: | DP 11/29/2017 | 1. DIMENSIONS ARE IN INCHES UNLESS OTHERWISE SPECIFIED | |
| APPROVED: | WM 11/29/2017 | 2. INTERPRET DIM AND TOL PER ASME Y14.5M-2009 | |
| DATE: | 11/28/2017 | 3. DIMENSIONAL LIMITS APPLY AFTER PLATING | |
| SCALE: | NTS | WEIGHT: | N/A |
| | | SHEET 7 OF 7 | |
| COPYRIGHT © 2017 BY DART AEROSPACE LTD <small>THIS DOCUMENT IS PRIVATE AND CONFIDENTIAL AND IS SUPPLIED ON THE EXPRESS CONDITION THAT IT IS NOT TO BE USED FOR ANY PURPOSE OR COPIED OR COMMUNICATED TO ANY OTHER PERSON WITHOUT WRITTEN PERMISSION FROM DART AEROSPACE LTD.</small> | | | |

DQA: _____ Date: _____

**WORK ORDER NON-CONFORMANCE / UPDATE**

QA Closed: _____ Date: _____

Work Order update only ☐

| |
|---|
| Work Order: _____ Part No. <u>RBEM623U1002102 Rev. C</u> NCR No. _____ | DISPOSITION Rework <input type="checkbox"/> Scrap <input type="checkbox"/> Use-as-is <input type="checkbox"/> Suspected Unapproved <input type="checkbox"/> | AGAINST DEPARTMENT/PROCESS <table style="width:100%; border: none;"> <tr> <td style="border: none;">Skid-tube <input type="checkbox"/></td> <td style="border: none;">Cross tube <input type="checkbox"/></td> <td style="border: none;">Water Jet <input type="checkbox"/></td> <td style="border: none;">Engineering <input type="checkbox"/></td> </tr> <tr> <td style="border: none;">Machining <input type="checkbox"/></td> <td style="border: none;">Small Fab <input type="checkbox"/></td> <td style="border: none;">Prod. Eng. Coord. <input type="checkbox"/></td> <td style="border: none;">Quality <input type="checkbox"/></td> </tr> <tr> <td style="border: none;">Thermoforming <input type="checkbox"/></td> <td style="border: none;">Finishing <input type="checkbox"/></td> <td style="border: none;">Rec/Store/Packaging <input type="checkbox"/></td> <td style="border: none;">Other <input type="checkbox"/></td> </tr> <tr> <td style="border: none;">Large Fab <input type="checkbox"/></td> <td style="border: none;">Composite <input type="checkbox"/></td> <td style="border: none;">Supplier <input type="checkbox"/></td> <td style="border: none;"></td> </tr>
| Date : _____ | Step #: _____ | QTY Effective : _____ | | MRB (QSI042) Approval May 4, 2018 | |
| Description Work Order Deviation | | Disposition | | Completed By | |
| McMaster Carr Cotter Pin 98338A175 must be replaced with MS24665-134 Cotter Pin | | - This deviation is acceptable. - The fit, form and function of the part will be as originally intended. | | Lead hand / Supervisor Approval Verification | |
| |
| | | | | QC / QA Coordinator Approval | |
| Root Cause | | FAULT CATEGORY | |
| <table style="width:100%; border: none;"> <tr><td style="border: none;">Environment</td><td style="border: none;"><input type="checkbox"/></td><td style="border: none;"><input type="checkbox"/></td><td style="border: none;">No Re-verification</td></tr> <tr><td style="border: none;">Design</td><td style="border: none;"><input type="checkbox"/></td><td style="border: none;"><input type="checkbox"/></td><td style="border: none;">Operator</td></tr> <tr><td style="border: none;">Doc/Data</td><td style="border: none;"><input type="checkbox"/></td><td style="border: none;"><input type="checkbox"/></td><td style="border: none;">Offset/Setup</td></tr> <tr><td style="border: none;">Equip/Tooling</td><td style="border: none;"><input type="checkbox"/></td><td style="border: none;"><input type="checkbox"/></td><td style="border: none;">Supplier</td></tr> <tr><td style="border: none;">Handling/Pre</td><td style="border: none;"><input type="checkbox"/></td><td style="border: none;"><input type="checkbox"/></td><td style="border: none;">Training</td></tr> <tr><td style="border: none;">Material</td><td style="border: none;"><input checked="" type="checkbox"/></td><td style="border: none;"><input type="checkbox"/></td><td style="border: none;">Use for Testing</td></tr> <tr><td style="border: none;">Internal Transport</td><td style="border: none;"><input type="checkbox"/></td><td style="border: none;"><input type="checkbox"/></td><td style="border: none;">Poor Information</td></tr> <tr><td style="border: none;">Tribal Knowledge</td><td style="border: none;"><input type="checkbox"/></td><td style="border: none;"><input type="checkbox"/></td><td style="border: none;">Rushing</td></tr> <tr><td style="border: none;">LOA</td><td style="border: none;"><input type="checkbox"/></td><td style="border: none;"><input type="checkbox"/></td><td style="border: none;">Product Improvement</td></tr> <tr><td style="border: none;">Substation</td><td style="border: none;"><input type="checkbox"/></td><td style="border: none;"><input type="checkbox"/></td><td style="border: none;">Process Improvement</td></tr> <tr><td style="border: none;">Past Expiry Date</td><td style="border: none;"><input type="checkbox"/></td><td style="border: none;"><input type="checkbox"/></td><td style="border: none;">Manufacturing Process</td></tr> <tr><td style="border: none;">Misidentified</td><td style="border: none;"><input type="checkbox"/></td><td style="border: none;"><input type="checkbox"/></td><td style="border: none;">Past Due</td></tr>Process Improvement | Past Expiry Date | <input type="checkbox"/> | <input type="checkbox"/> | Manufacturing Process | Misidentified | <input type="checkbox"/> | <input type="checkbox"/> | Past Due | <table style="width:100%; border: none;"> <tr><td style="border: none;"><input type="checkbox"/></td><td style="border: none;">Pressure/Forced</td></tr> <tr><td style="border: none;"><input type="checkbox"/></td><td style="border: none;">Bending</td></tr> <tr><td style="border: none;"><input type="checkbox"/></td><td style="border: none;">Centre Not Concentric</td></tr> <tr><td style="border: none;"><input type="checkbox"/></td><td style="border: none;">Cracks</td></tr> <tr><td style="border: none;"><input type="checkbox"/></td><td style="border: none;">Crimp/Kink/Ripple/Wave</td></tr> <tr><td style="border: none;"><input type="checkbox"/></td><td style="border: none;">Cuffs</td></tr> <tr><td style="border: none;"><input type="checkbox"/></td><td style="border: none;">Crushing</td></tr> <tr><td style="border: none;"><input type="checkbox"/></td><td style="border: none;">Heat Treat</td></tr> <tr><td style="border: none;"><input type="checkbox"/></td><td style="border: none;">Wave/Twist in Tube</td></tr> <tr><td style="border: none;"><input type="checkbox"/></td><td style="border: none;">Marks/Chatter</td></tr> </table> | <input type="checkbox"/> | Pressure/Forced | <input type="checkbox"/> | Bending | <input type="checkbox"/> | Centre Not Concentric | <input type="checkbox"/> | Cracks | <input type="checkbox"/> | Crimp/Kink/Ripple/Wave | <input type="checkbox"/> | Cuffs | <input type="checkbox"/> | Crushing | <input type="checkbox"/> | Heat Treat | <input type="checkbox"/> | Wave/Twist in Tube | <input type="checkbox"/> | Marks/Chatter | <table style="width:100%; border: none;"> <tr><td style="border: none;"><input type="checkbox"/></td><td style="border: none;">Temperature/Cure</td></tr> <tr><td style="border: none;"><input type="checkbox"/></td><td style="border: none;">Set-up</td></tr> <tr><td style="border: none;"><input type="checkbox"/></td><td style="border: none;">BOM/Route</td></tr> <tr><td style="border: none;"><input type="checkbox"/></td><td style="border: none;">Broken/Damage/Defect</td></tr> <tr><td style="border: none;"><input type="checkbox"/></td><td style="border: none;">Inspection Incomplete/Unqualified</td></tr> <tr><td style="border: none;"><input type="checkbox"/></td><td style="border: none;">Contamination</td></tr> <tr><td style="border: none;"><input type="checkbox"/></td><td style="border: none;">Countersink</td></tr> <tr><td style="border: none;"><input type="checkbox"/></td><td style="border: none;">Cut Too Short</td></tr> <tr><td style="border: none;"><input type="checkbox"/></td><td style="border: none;">Instructions Incomplete/Unclear</td></tr> <tr><td style="border: none;"><input type="checkbox"/></td><td style="border: none;">Drill Holes</td></tr> </table> | | | <input type="checkbox"/> | Temperature/Cure | <input type="checkbox"/> | Set-up | <input type="checkbox"/> | BOM/Route | <input type="checkbox"/> | Broken/Damage/Defect | <input type="checkbox"/> | Inspection Incomplete/Unqualified | <input type="checkbox"/> | Contamination | <input type="checkbox"/> | Countersink | <input type="checkbox"/> | Cut Too Short | <input type="checkbox"/> | Instructions Incomplete/Unclear | <input type="checkbox"/> | Drill Holes | <table style="width:100%; border: none;"> <tr><td style="border: none;"><input type="checkbox"/></td><td style="border: none;">Power Loss/Surge</td></tr> <tr><td style="border: none;"><input type="checkbox"/></td><td style="border: none;">Folio/Program</td></tr> <tr><td style="border: none;"><input type="checkbox"/></td><td style="border: none;">Grain</td></tr> <tr><td style="border: none;"><input type="checkbox"/></td><td style="border: none;">Weld</td></tr> <tr><td style="border: none;"><input type="checkbox"/></td><td style="border: none;">Wrong Stock Pulled</td></tr> <tr><td style="border: none;"><input type="checkbox"/></td><td style="border: none;">Out of Sequence</td></tr> <tr><td style="border: none;"><input type="checkbox"/></td><td style="border: none;">Off-set</td></tr> <tr><td style="border: none;"><input type="checkbox"/></td><td style="border: none;">Mislabeled</td></tr> <tr><td style="border: none;"><input type="checkbox"/></td><td style="border: none;">Fit/Function</td></tr> <tr><td style="border: none;"><input type="checkbox"/></td><td style="border: none;">Misaligned/off center</td></tr> </table> | <input type="checkbox"/> | Power Loss/Surge | <input type="checkbox"/> | Folio/Program | <input type="checkbox"/> | Grain | <input type="checkbox"/> | Weld | <input type="checkbox"/> | Wrong Stock Pulled | <input type="checkbox"/> | Out of Sequence | <input type="checkbox"/> | Off-set | <input type="checkbox"/> | Mislabeled | <input type="checkbox"/> | Fit/Function | <input type="checkbox"/> | Misaligned/off center | <table style="width:100%; border: none;"> <tr><td style="border: none;"><input type="checkbox"/></td><td style="border: none;">Positioned Wrong</td></tr> <tr><td style="border: none;"><input type="checkbox"/></td><td style="border: none;">Outside Dimensions</td></tr> <tr><td style="border: none;"><input type="checkbox"/></td><td style="border: none;">Over/Under tolerance</td></tr> <tr><td style="border: none;"><input type="checkbox"/></td><td style="border: none;">Part Incorrect</td></tr> <tr><td style="border: none;"><input type="checkbox"/></td><td style="border: none;">Part Lost/Missing</td></tr> <tr><td style="border: none;"><input type="checkbox"/></td><td style="border: none;">Part Moved</td></tr> <tr><td style="border: none;"><input type="checkbox"/></td><td style="border: none;">Drawing</td></tr> <tr><td style="border: none;"><input type="checkbox"/></td><td style="border: none;">Finish</td></tr> <tr><td style="border: none;"><input type="checkbox"/></td><td style="border: none;">Misread</td></tr> <tr><td style="border: none;"><input type="checkbox"/></td><td style="border: none;">Turning Sequence</td></tr> </table> | <input type="checkbox"/> | Positioned Wrong | <input type="checkbox"/> | Outside Dimensions | <input type="checkbox"/> | Over/Under tolerance | <input type="checkbox"/> | Part Incorrect | <input type="checkbox"/> | Part Lost/Missing | <input type="checkbox"/> | Part Moved | <input type="checkbox"/> | Drawing | <input type="checkbox"/> | Finish | <input type="checkbox"/> | Misread | <input type="checkbox"/> | Turning Sequence |
| Environment | <input type="checkbox"/> | <input type="checkbox"/> | No Re-verification | |
| Design | <input type="checkbox"/> | <input type="checkbox"/> | Operator | |
| Doc/Data | <input type="checkbox"/> | <input type="checkbox"/> | Offset/Setup | |
| Equip/Tooling | <input type="checkbox"/> | <input type="checkbox"/> | Supplier | |
| Handling/Pre | <input type="checkbox"/> | <input type="checkbox"/> | Training | |
| Material | <input checked="" type="checkbox"/> | <input type="checkbox"/> | Use for Testing | |
| Internal Transport | <input type="checkbox"/> | <input type="checkbox"/> | Poor Information | |
| Tribal Knowledge | <input type="checkbox"/> | <input type="checkbox"/> | Rushing | |
| LOA | <input type="checkbox"/> | <input type="checkbox"/> | Product Improvement | |
| Substation | <input type="checkbox"/> | <input type="checkbox"/> | Process Improvement | |
| Past Expiry Date | <input type="checkbox"/> | <input type="checkbox"/> | Manufacturing Process | |
| Misidentified | <input type="checkbox"/> | <input type="checkbox"/> | Past Due | |
| OTHER : <input type="checkbox"/> | |